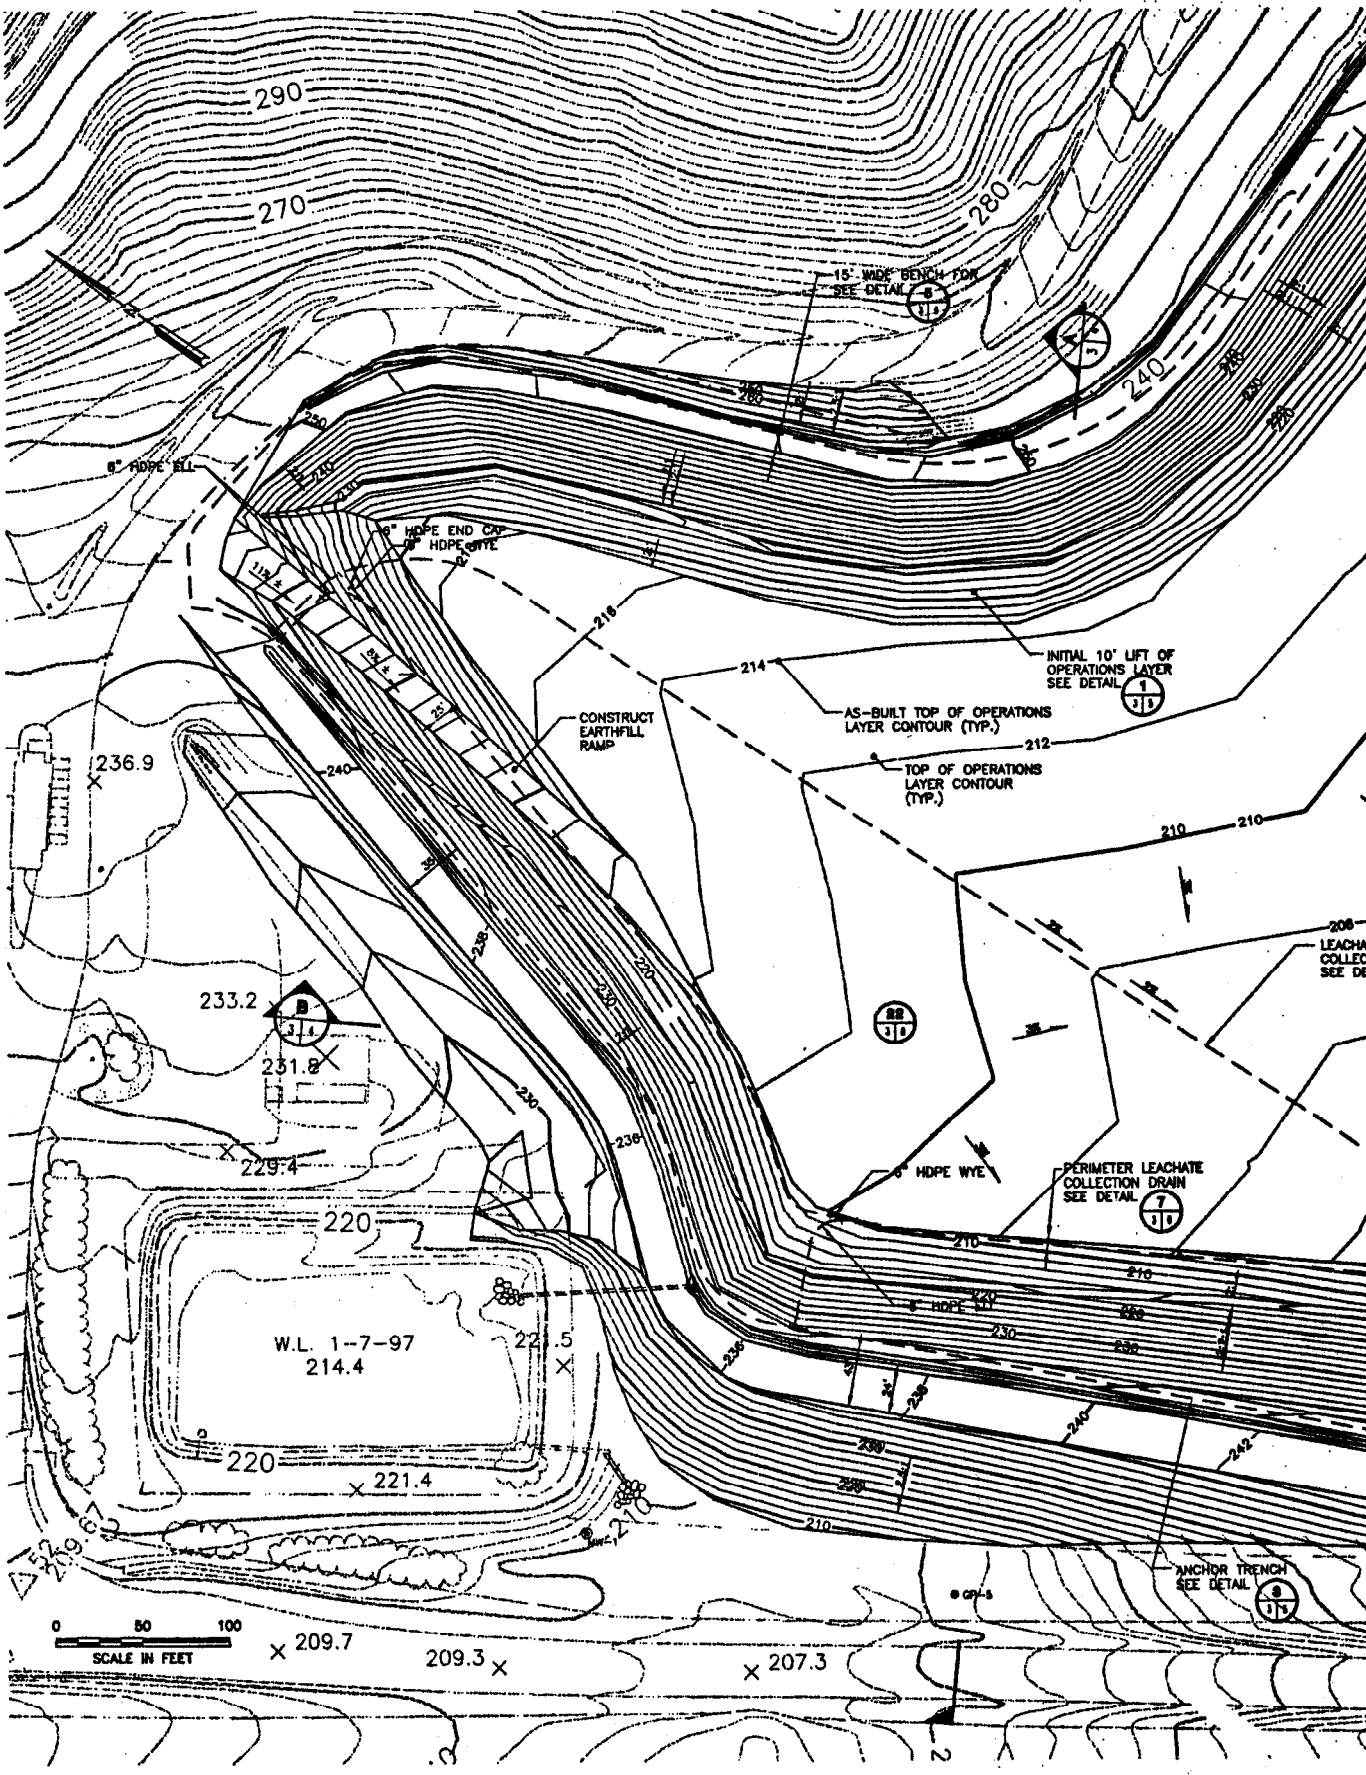
290
270
280
240
15' WIDE BENCH FOR SEE DETAIL 6
6" HDPE ELL
6" HDPE END CAP OR HDPE WYE
INITIAL 10' LIFT OF OPERATIONS LAYER SEE DETAIL 1
AS-BUILT TOP OF OPERATIONS LAYER CONTOUR (TYP.)
TOP OF OPERATIONS LAYER CONTOUR (TYP.)
CONSTRUCT EARTHFILL RAMP
236.9
233.2
231.8
229.4
220
W.L. 1-7-97
214.4
221.5
221.4
209.7
209.3
207.3
6" HDPE WYE
PERIMETER LEACHATE COLLECTION DRAIN SEE DETAIL 7
ANCHOR TRENCH SEE DETAIL 8
0 50 100
SCALE IN FEET

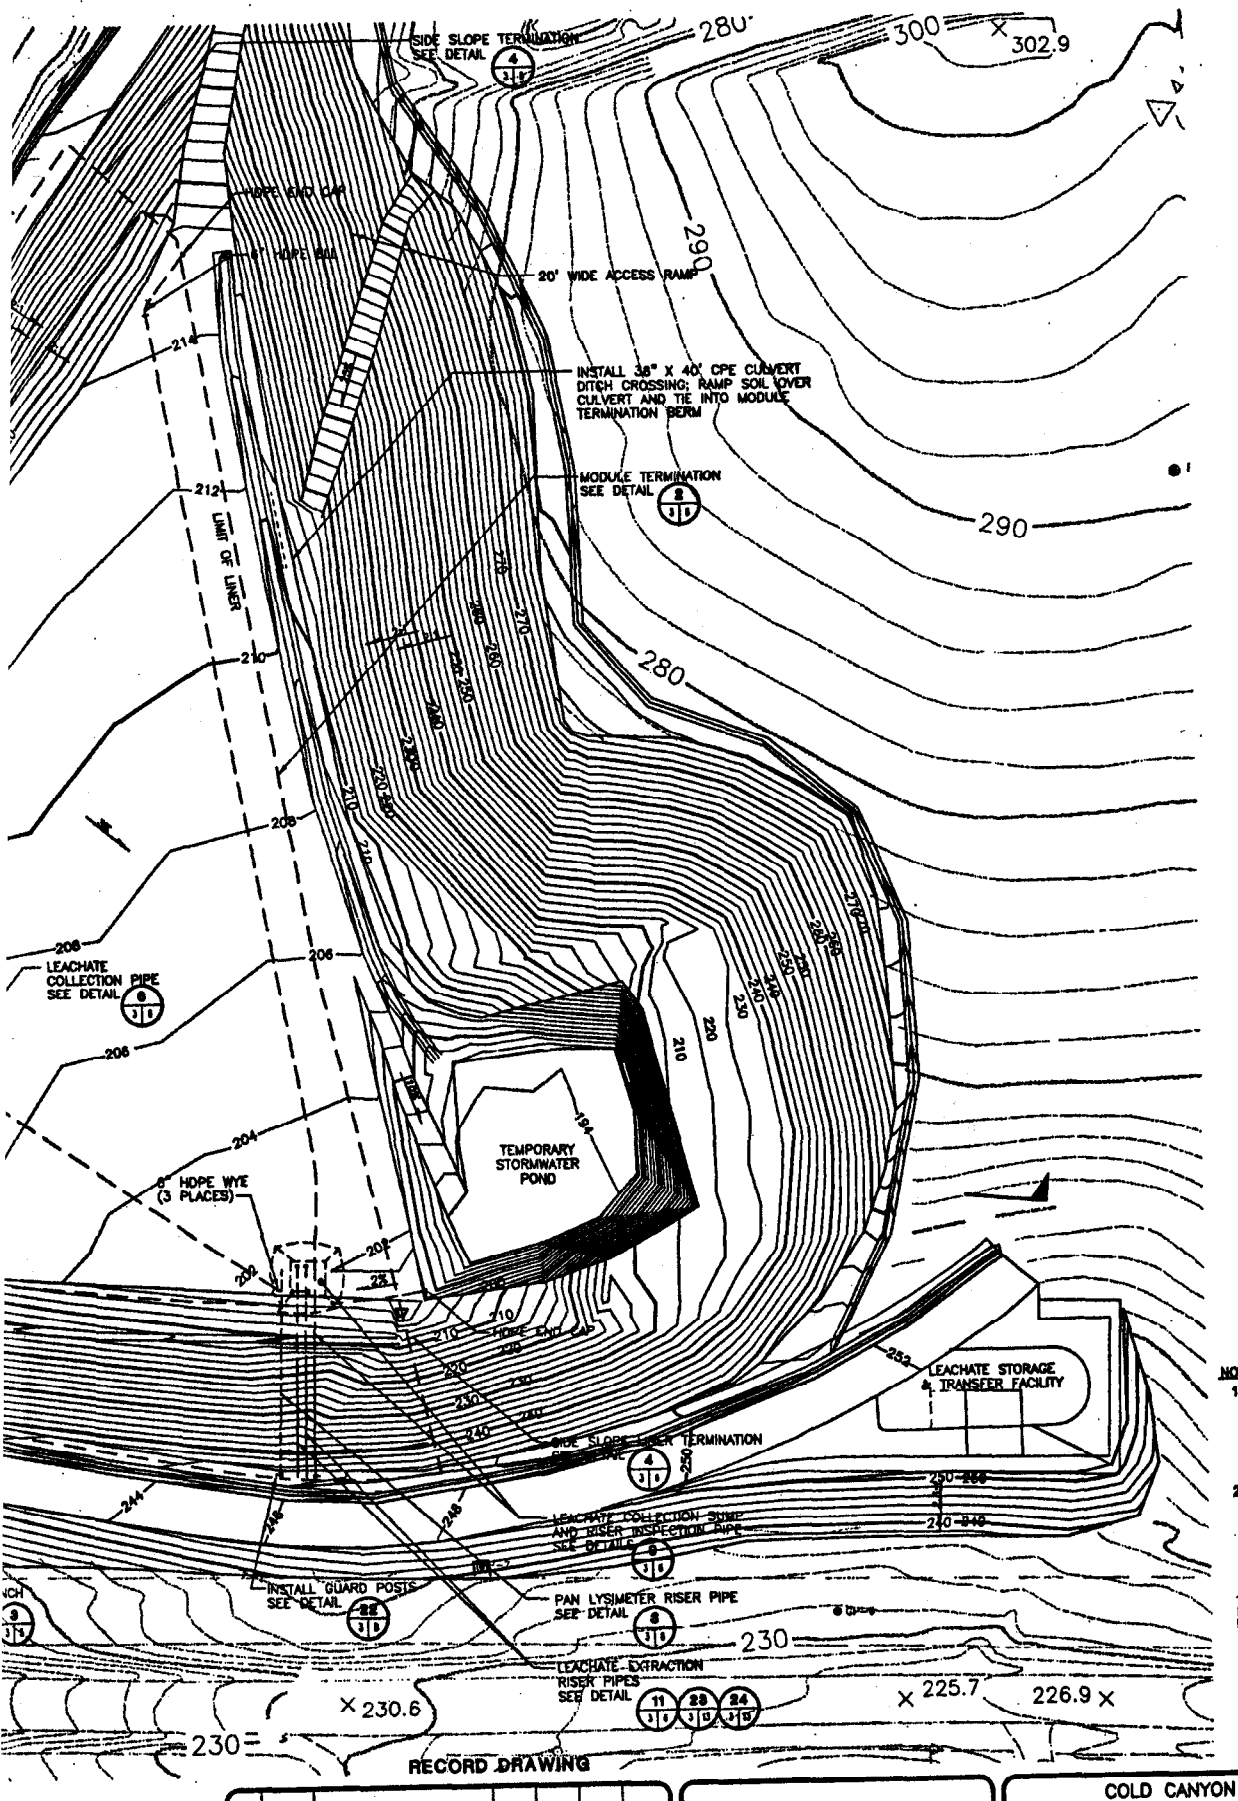

NOTES

1. FOR BASE AND SIDE SLOPE LINER SYSTEM AND SEQUENCE OF PLACEMENT OF OPERATIONS LAYER, SEE DETAIL 1 3|5
2. SEE DRAWING 11 FOR 2" FORCE MAIN ALIGNMENT.

Topographic base compiled using photogrammetric methods by Golden State Aerial Surveys, San Luis Obispo, CA 93401
Date of photography: January 7, 1997

REV	DATE	DESCRIPTION	DWN BY	DES BY	CHK BY	APP BY
1	1/7/00	RECORD DRAWING	KLT	—	RDH	RDH
0	9/9/99	ISSUED FOR CONSTRUCTION	KLT	SER	ESA	RDH

DATE OF ISSUE AUG. 1998 DWN BY KLT DES BY SER CHK BY ESA APP BY RDH

EMCON

COLD CANYON LAND FILL, INC.
COLD CANYON LANDFILL
SAN LUIS OBISPO COUNTY, CALIFORNIA

LINER AND LEACHATE COLLECTION AND REMOVAL SYSTEM PLAN

DRAWING NO. 3

PROJECT NO. 20142-001.033